


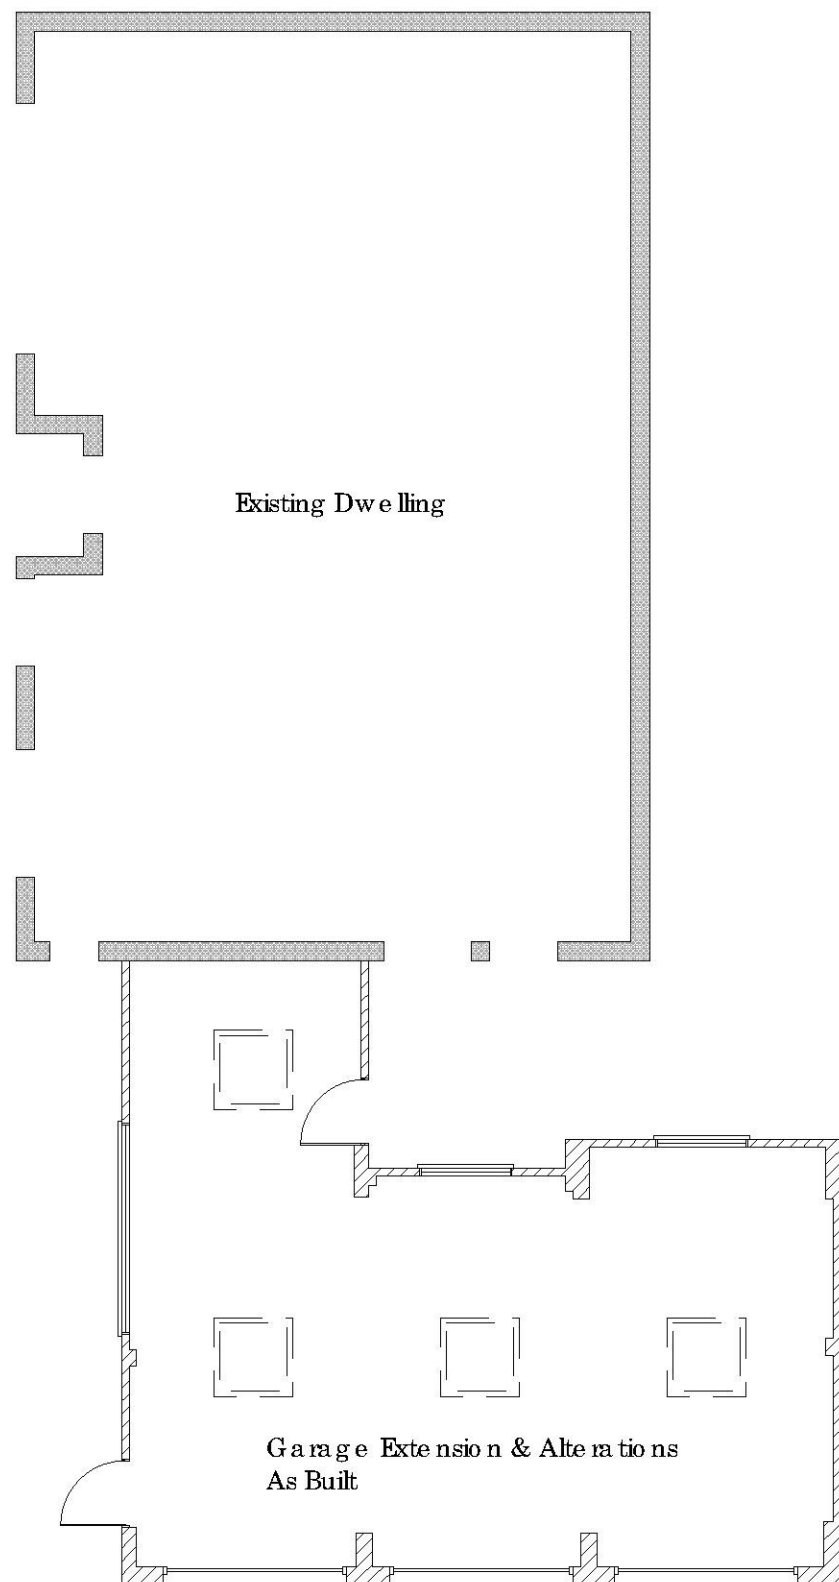


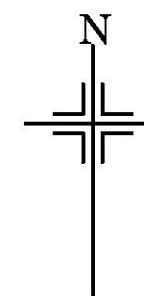

Block Plan 1:500

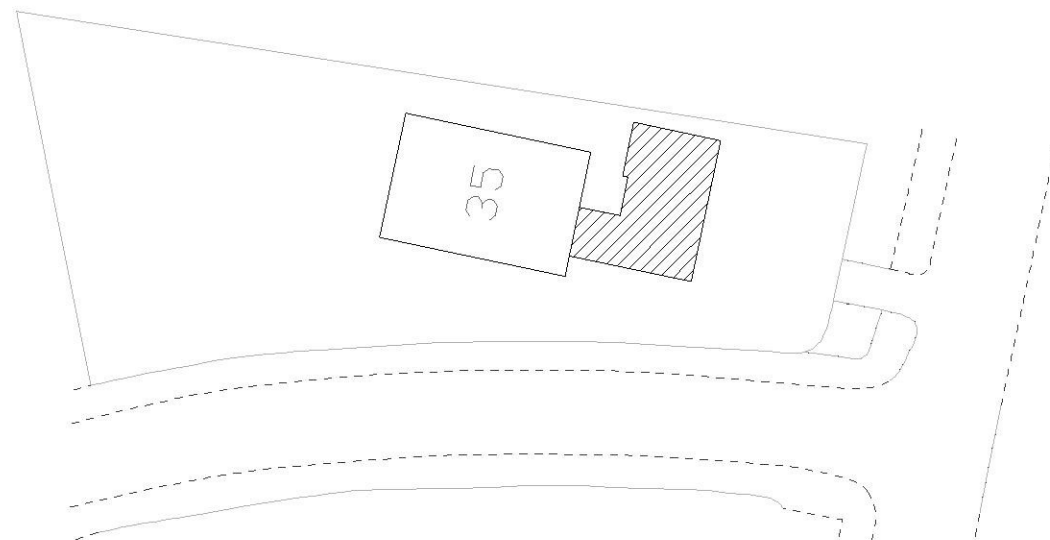

Roof Plan

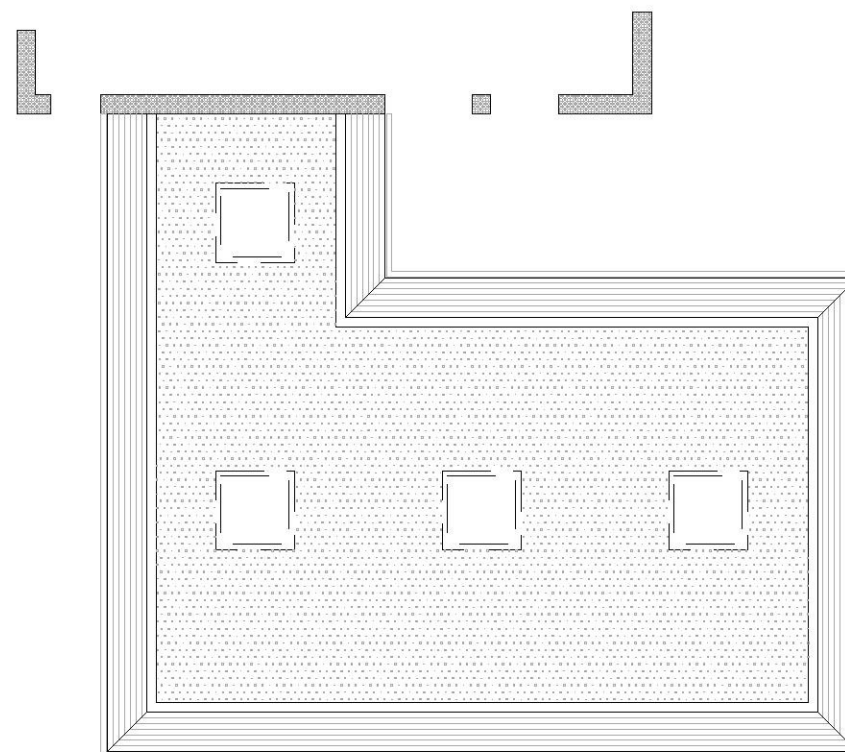

Scale Bar - A3 - 1:100 20

10

8

6

4

2

0

 KENT BUILDING CONTROL LTD			
rev.	date	amendment	
Kent Building Control Ltd 134 High Street Hythe Kent CT21 5LB 01303 656001			
client	Mr R Lewis		
project	35 Wear Bay Road Folkestone CT19 6BH		
drawing title	As Built Plans		
scale	1:100	date	26.04.19
drawn by	KT		
drawn no.	KBC/ 19/ 067/ 002	rev.	0