
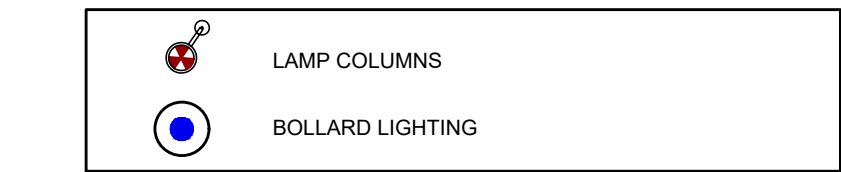


Rev: Date:
A: 17/05/21 PUBLIC FOOTPATH LINK TO ROYAL MILITARY AVENUE REMOVE IN FRONT OF PLOT 174. PA34 SUBSTITUTED FOR PA30's ON PLOTS 164 & 165, GARDEN LENGTHS OF 161-163 ADJUSTED TO SUIT. PARKING AND FRONT ACCESS PATHS ADJUSTED FOR PLOTS 164 & 165.
B: 19/05/21 FRONT BAYS & EXTENDED PORCH CANOPY ADDED TO PLOTS 160, 161 & 162.
C: 02/06/21 SALES UNIT FOOTPRINT ROTATED ON PLOT 170 TO MATCH 'AS-BUILT'. PORCH POSTS AND SIDE DOOR OMITTED FROM PLOT 166. PROPOSED TREE LOCATIONS ADDED/UPDATED.
D: 08/06/21 EXISTING FEATURES FOR PLOTS 170-174 & SURROUNDING AREA UPDATED TO SUIT SURVEY Dtg. 33173 BWLS-01 (7-5-21) WITH SLIGHT ADJUSTMENT TO FOOTPRINTS. EXISTING LAMP COLUMN SHOWN ADJACENT PLOT 169. ELECTRICAL SUPPLY CABINET INDICATED ADJACENT TO ROYAL MILITARY Ave. ROAD NAMES ADDED. SALES CENTRE EXISTING GAS METER RELOCATED TO SUIT 'AS-BUILT'.
E: 19/07/21 PLOT 170 CONFIRMED AS 4 BED. TREES IN GRILLES RELOCATED FROM IN FRONT OF PLOT 170 TO ADJACENT TO VISITOR PARKING BAYS TO PROVIDE ACCESS FOR FIRE APPLIANCE.
F: 16/08/21 EXISTING BLOCK PAVED ACCESS RETAINED FROM ROYAL MILITARY AVE WITH BOLLARD ADDED. RCP RELOCATED FURTHER SOUTH IN FRONT OF PLOT 170. NEW RCP ADDED IN FRONT OF PLOT 160. NEW GATE AND ACCESS PATH ADDED TO SIDE OF PLOT 174.

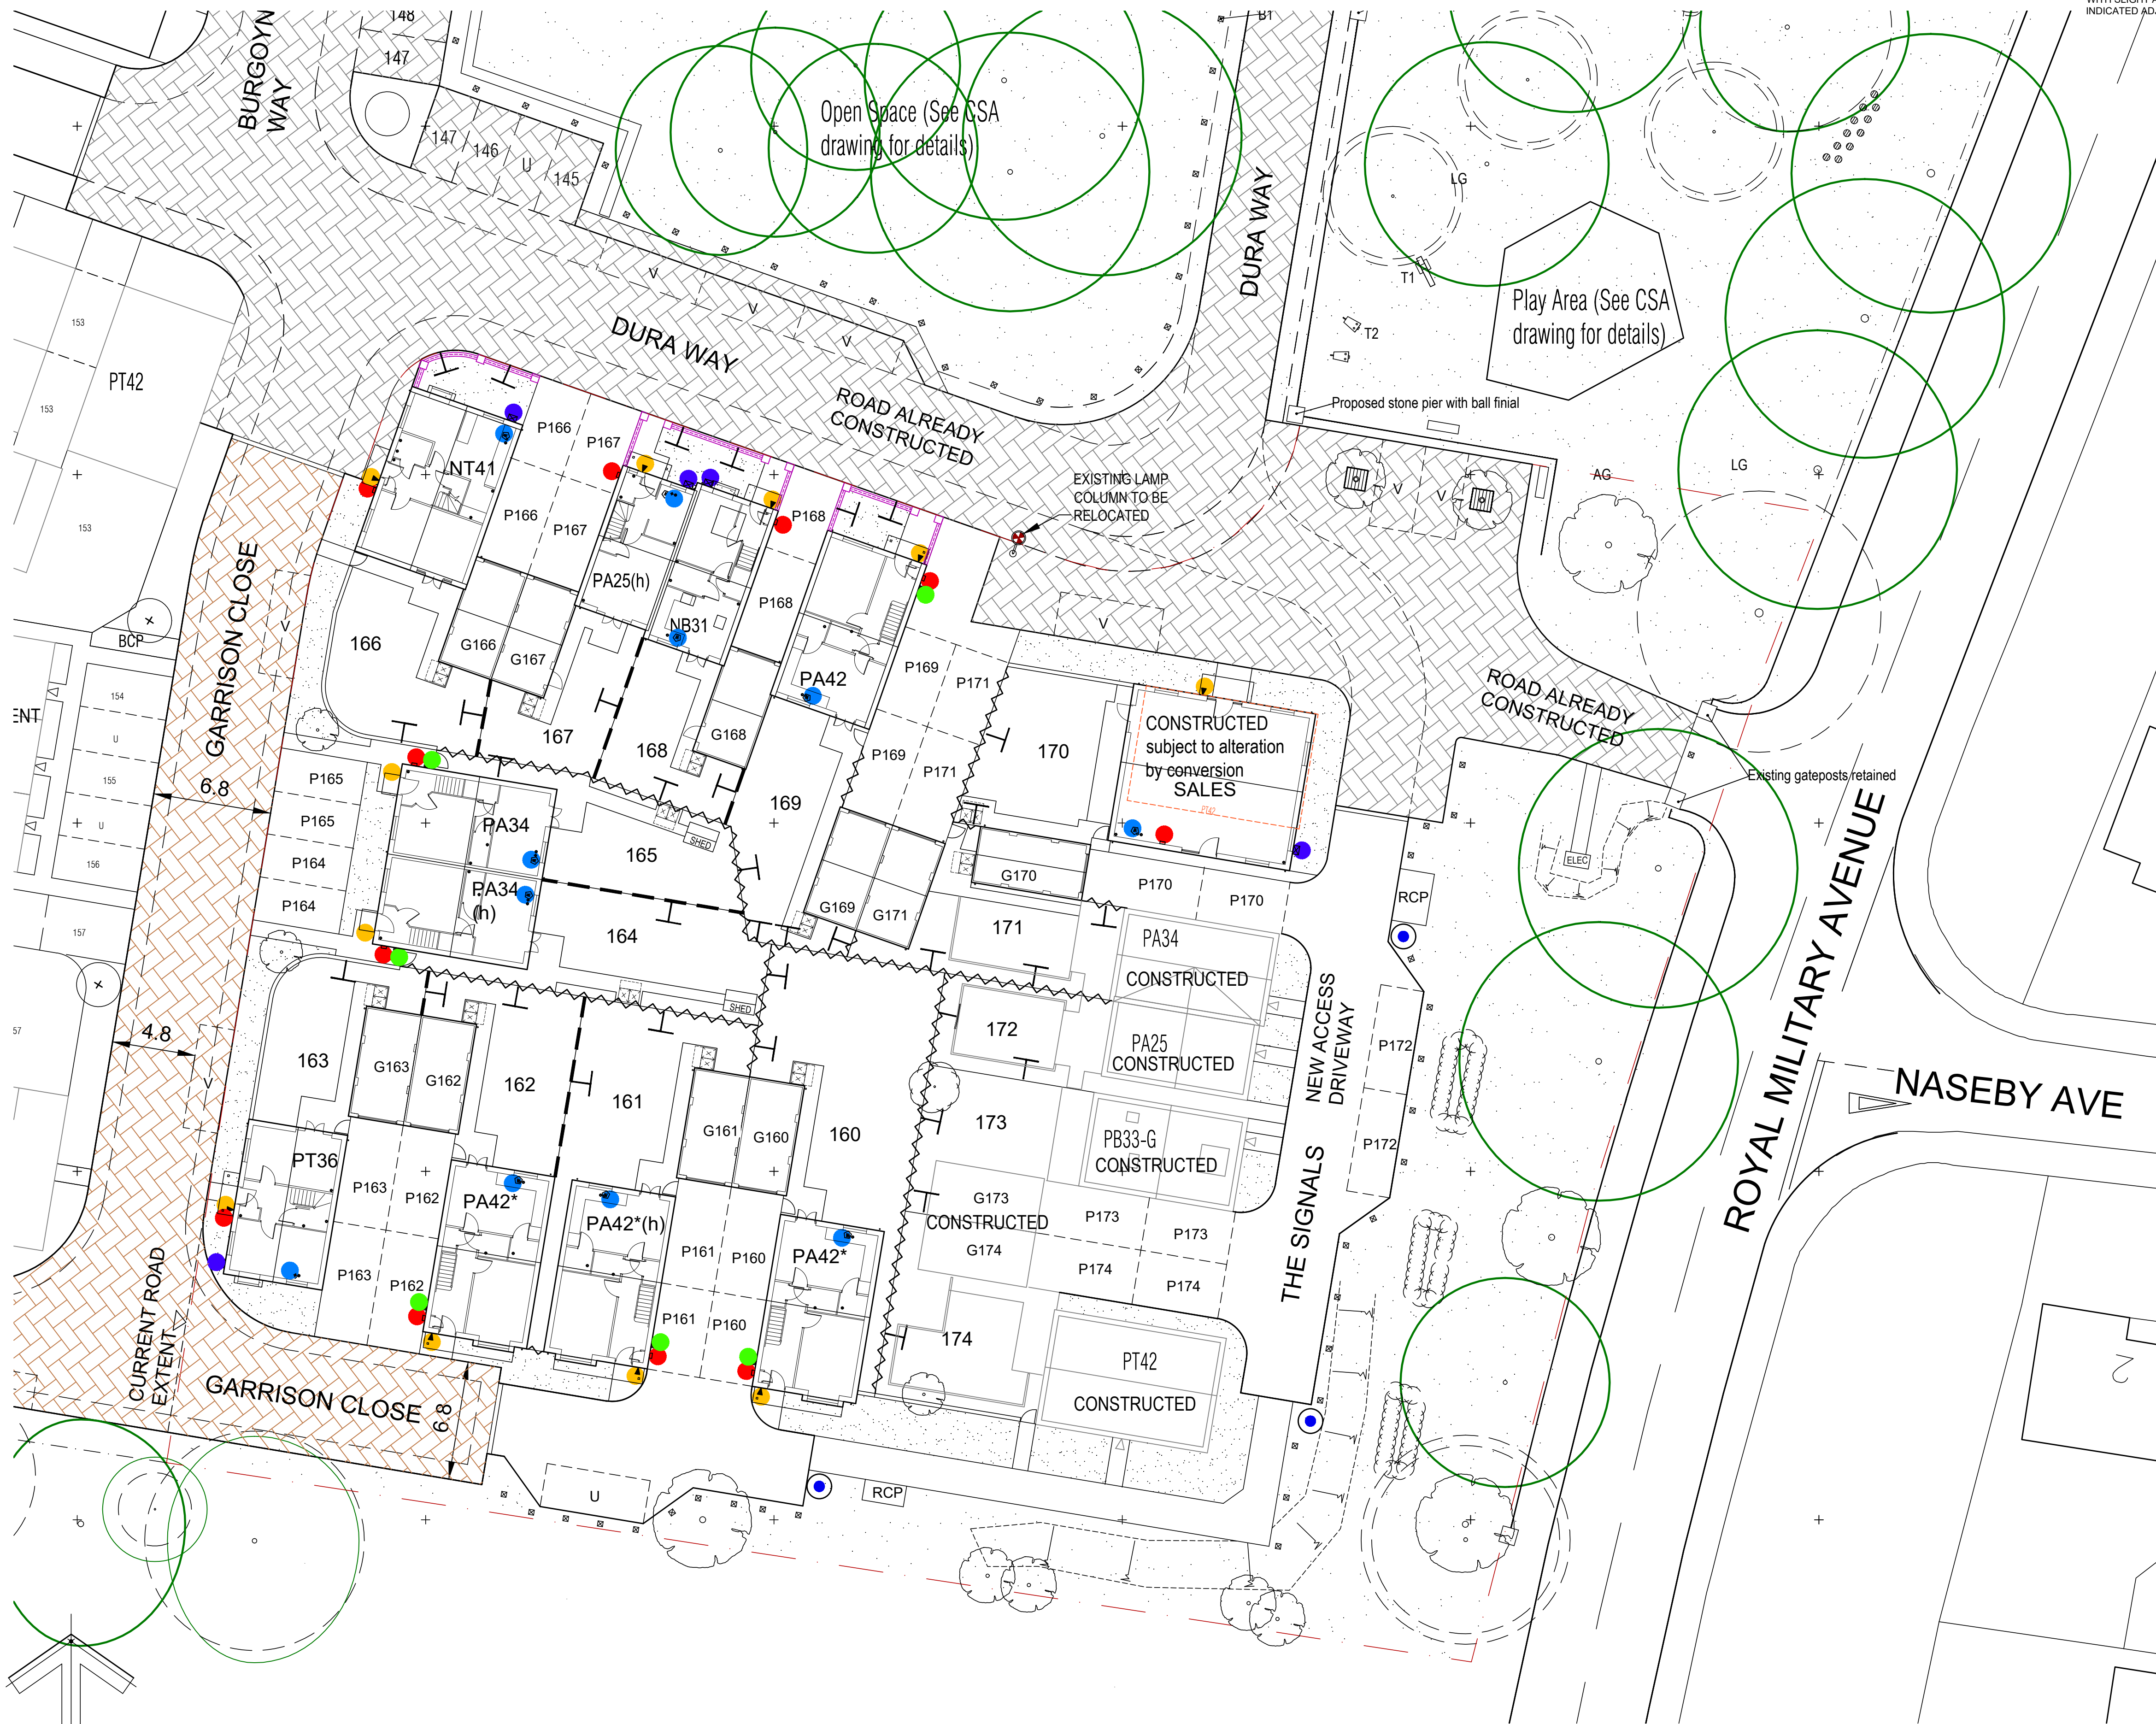

- UTILITIES LEGEND**
- ELECTRIC WALL METER POSITION
 - GAS METER POSITION - BUILT IN
 - SEMI CONCEALED GAS METER POSITION (GROUND BOX)
 - WATER INTAKE POSITION
 - TELECOM POSITION
- REFER TO WORKING DRAWINGS FOR FULL SERVICE DETAILS

SCHEDULE OF UNITS			
NT41	4 BED HOUSE	TRUSDALE	1
PA42	4 BED HOUSE	LYDFORD	4
NB31	4 BED HOUSE	BRAXTON	1
PT36	3 BED HOUSE	EASEDALE	1
PA34	3 BED HOUSE	GOSFORD	2
PA25	2 BED HOUSE	CANFORD	1
			TOTAL
			10
CONVERSION SALES	4 BED HOUSE		1
			TOTAL
			11
AS-BUILT FOR PRIVATE SALE			
PT42	4 BED HOUSE	KENTDALE	1
PA34	3 BED HOUSE	GOSFORD	1
PA33-G	3 BED HOUSE	FLATFORD	1
PA25	2 BED HOUSE	CANFORD	1
			TOTAL
			4
* ASTERISK SIGNIFIES PLOT SPECIFIC VARIATIONS (h) - HANDED UNITS			

Taylor Wimpey

FCS BUILDING DESIGN CONSULTANTS LTD E1 East Court, South Park Business Village, Enterprise Road, Maidstone, Kent ME15 5LF Tel: 01622 665585 Email: mail@fcs-limited.co.uk

Client/Job title: TAYLOR WIMPEY
THE STADIUM - SALES AREA

Drawing: UTILITY LAYOUT
PLOTS 160-174

Scale: 1:200@A1 Date: MAY 2021 Drawn: M.J Checked: FCS Drawing No: 1599/03 Rev: F

DO NOT SCALE Report any errors or omissions, if in doubt refer to Architect. Check all dimensions on site prior to commencing the works or preparing any shop drawings. This drawing is copyright.