


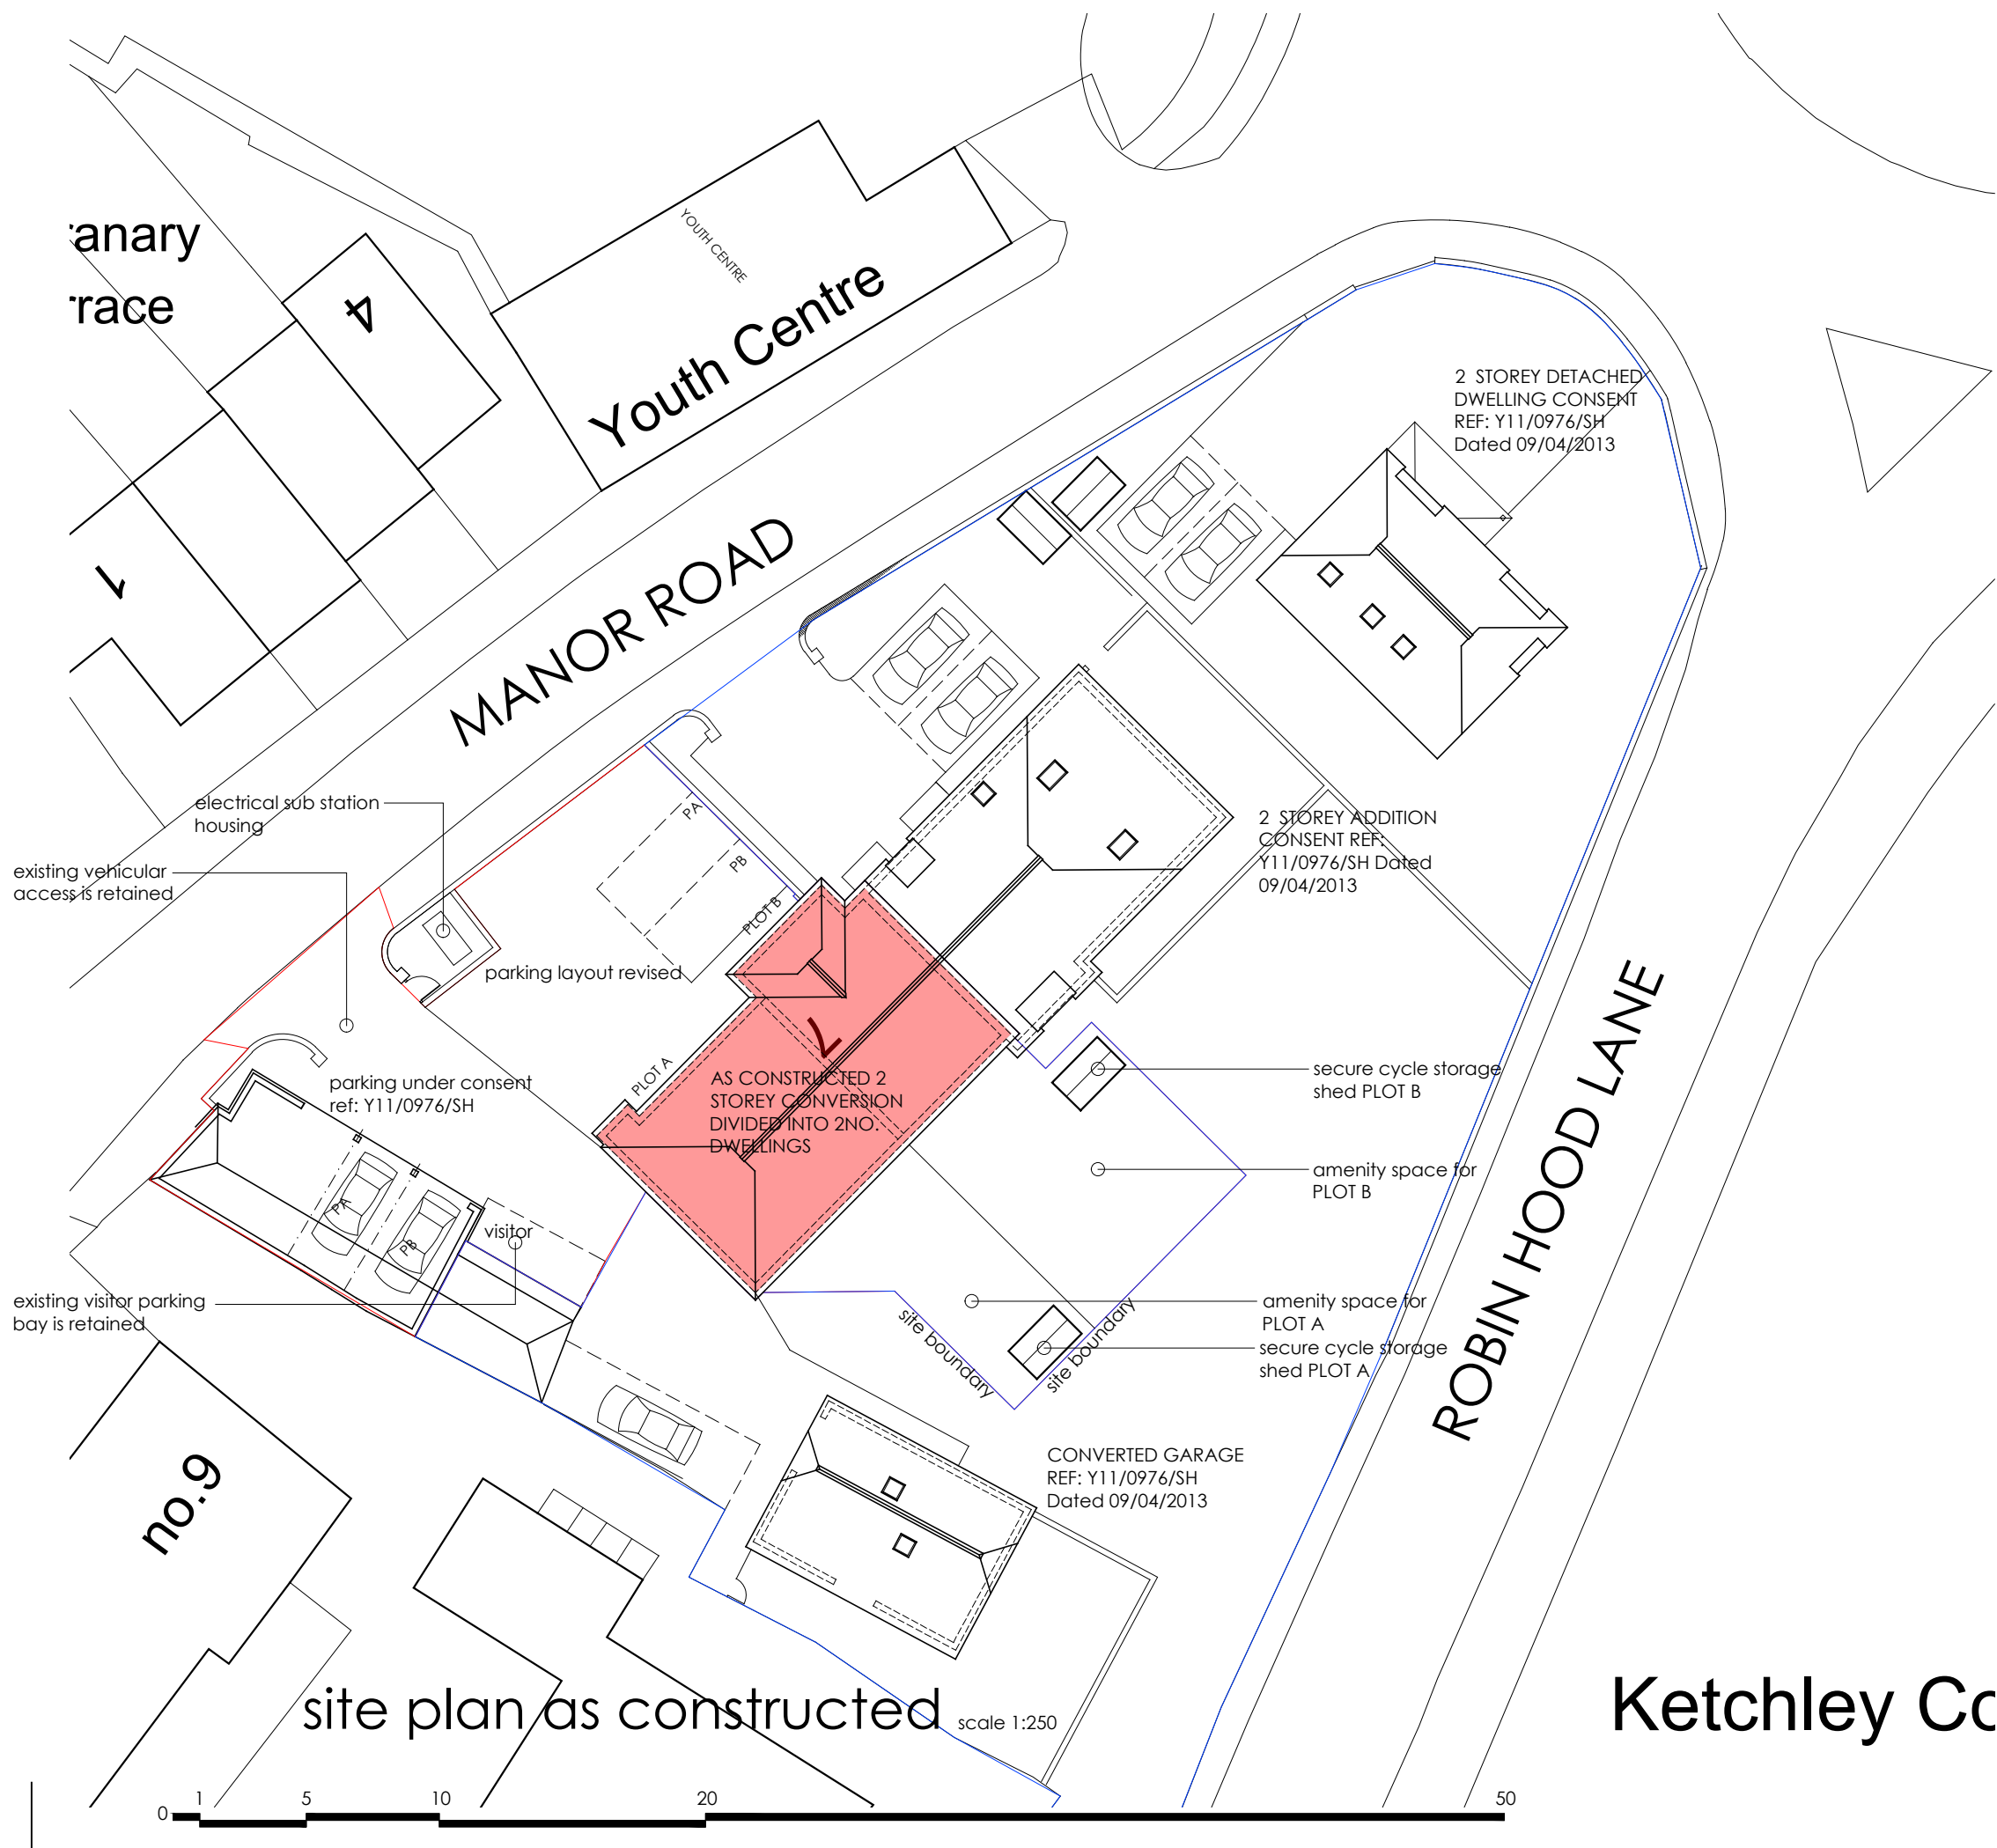

RETROSPECTIVE PLANNING APPLICATION

Revision: Description: Date:

GARYtidwell ASSOCIATES LIMITED
architecture - planning - construction technology
The Old Square, The Street, Woodnesborough, Kent . CT13 0NQ.
T: 07599 916454 E: garytidwell@hotmail.co.uk

Client:
MR. & MRS. CARTWRIGHT
Project:
7 MANOR ROAD
LYDD
KENT TN29 9HR

Title:
Site Plan as Constructed

Scale: 1:250@ A3
Date: MAR 24

Drawing Number:

Drawn:
GT

Revision:

01.850.10

PO