Registered Office:
Newington House
237 Southwark Bridge Road
London SE1 6NP

Registered in England and Wales No: 3870728

Company:
UK Power Networks
(Operations) Limited

Our Reference; 8500331779

Planning Office
Folkestone & Hythe District Council
Planning Department
Civic Centre
Folkestone
CT20 2QY

15th April 2026

Dear Sir/Madam,

Electricity Act 1989
Overhead Line (Exemption) (England & Wales) Regulations 2009
Statutory Instrument 2009 No. 640 Electricity, Paragraph 3 (1)

This notice is being given to your Council under The Overhead Lines (Exemption) (England & Wales) Regulation 2009.

Under this exemption, your Authority is required to determine, within 6 weeks of receipt of this notice, whether it is considered that the proposal is likely to have a significant adverse effect on the environment.

The works associated with this proposal will commence on site on or after the expiry of the required six weeks notice, unless it becomes necessary to apply to the Secretary of State for Trade and Industry for his consent.

Particulars of proposal:

Location: The Pilot Inn, Batter Road, Lydd on Sea, Dungeness, TN29 9NJ

Plan No: 8500331779


Details of proposal: Removal of 1 electricity pole and stay, and installation of 2 electricity poles including 1 stay per pole, and replacement of 1 stay on existing pole. Diversion of existing overhead network from existing poles to new pole positions. New poles to be same height as existing poles. Works to enable upgraded connection to customer premises. All works are **outside** of SSSI or RAMSAR designated land and within customer land or public highway.

[redacted]

Cris Whymark
UK Power Networks
Consent Coordinator
[redacted]

Return Address:
UK Power Networks
Property & Consents
Bircholt Road
Park Wood Maidstone
ME15 9XH
cris.whymark@ukpowernetworks.co.uk
M : 07907 978701

Title: (NTR) The Pilot, Battery Road, Dungeness TN29 9NJ | JOB NO: 8500331779-1-500-001 | PROPOSAL PLOT

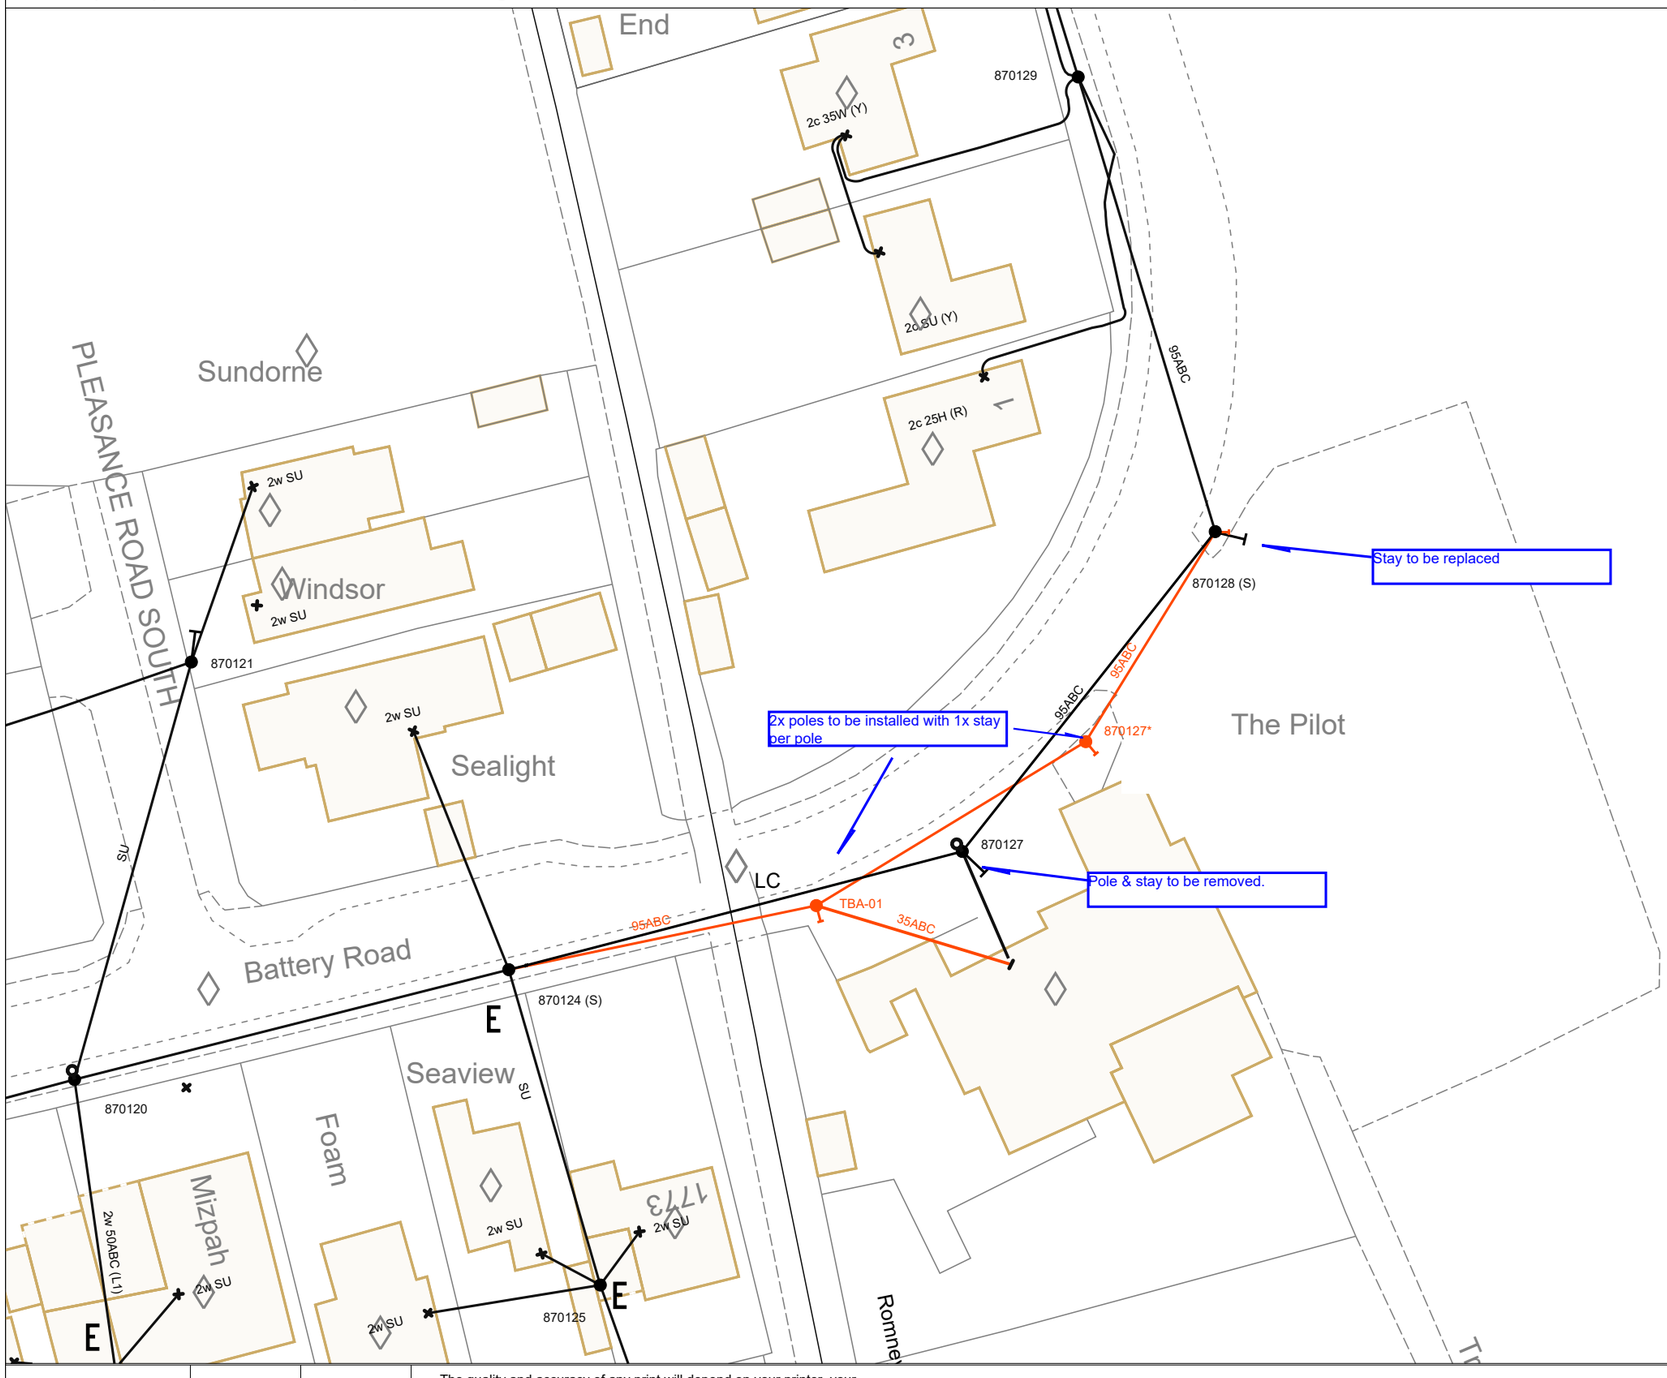

Description	Existing	Proposed
LV Cable or Line		
HV Cable or Line		
EHV Cable or Line Approx. position		
Ductline	[ ]	[ ]
Pole & Street Furniture	● ○	● ○
Substation & Link Box	□ ▭	▣ ▭

The quality and accuracy of any print will depend on your printer, your computer and its print settings. Measurements scaled from this plan may not match measurements between the same points on the ground.

0m 5m 10m 15m 20m 25m 30m 35m 40m 45m 50m 55m 60m 65m 70m

1. The position of the apparatus shown on this drawing is believed to be correct but the original landmarks may have been altered since the apparatus was installed.
2. The exact position of the apparatus should be verified - use approved cable avoidance tools prior to excavation using suitable hand tools.
3. It is essential that trial holes are carefully made avoiding the use of mechanical tools or picks until the exact location of all cables have been determined.
4. It must be assumed that each property and item of street furniture has an electricity supply. Service cables shown only where known.
5. All cables must be treated as being live unless proved otherwise by UK Power Networks.
6. The information provided must be given to all people working near UK Power Networks plant & equipment. Do not use plans more than 3 months after the issue date for excavation purposes.
7. Please be aware that electric cables/lines belonging to other owners of licensed electricity distribution systems may be present and it is your responsibility to identify their location.

VISITING AN OPEN POINT? Please mark on this plan all locations visited and open points as found, then return updated map to your Business Unit - Thank You.

1. UK Power Networks does not warrant that the information provided to you is correct. You rely upon it at your own risk.
2. UK Power Networks does not exclude or limit its liability if it causes the death of any person or causes personal injury to a person where such death or personal injury is caused by its negligence.
3. Subject to paragraph 2 UK Power Networks has no liability to you in contract, in tort (including negligence), for breach of statutory duty or otherwise for any loss, damage, cost, claims, demands, or expenses that you or any third party may suffer or incur as a result of using the information provided whether for physical damage to property or for any economic loss (including without limitation loss of profit, loss of opportunity, loss of savings, loss of goodwill, loss of business, loss of use) or any special or consequential loss or damage whatsoever.
4. This plan has been provided to you on the basis of the terms of use set out in the covering letter that accompanies this plan. If you do not accept and/or do not understand the terms of use set out in the covering letter you must not use the plan and you must return it to the sender of the letter.
5. You are responsible for the security of the information provided to you. It must not be given, sold or made available upon payment of a fee to a third party.

Contact UK Power Networks on 0800 056 5866 for details of EHV Cable routes before commencing work.

Grid Ref: TR 09098 18629

Scale: 1:500
(when Plotted at A3)

Plotted on: 02/05/2025

Plotted by: Tony Warren

UK Power Networks

Plan Provision

CHECK IT OUT BEFORE YOU DIG IT OUT
CALL 0800 056 5866
EMERGENCY- If you damage a cable or line
Phone 0800 096 3766 (24hrs) URGENTLY

LOOK OUT LOOK UP

ALWAYS LOOK UP BEFORE YOU START WORK
Refer To HSE Guidance note GS6

Maps produced at 1:2500 scale are LV Geo-Schematics which show LV mains cables and overhead lines (in some cases all voltages). Prior to carrying out excavations you must refer to the 1:500 records to determine the location of all known underground plant and equipment.

Reproduced by permission of Ordnance Survey on behalf of HMSO. (c) Crown copyright and database right 2025. All rights reserved. Ordnance Survey Licence number AC0000850810. Data has been added to the Ordnance Survey base map; all proprietary rights in such additional data are and shall remain the exclusive property of (c) South Eastern Power Networks plc or London Power Networks plc each being a distribution licensee under section 6(1)(c) of the Electricity Act 1989 for the relevant distribution services area as that term is defined in such licensee's distribution licence. All rights in such data reserved.